


PROPERTY ADDRESS: 111 S HIMES AVENUE, TAMPA, FLORIDA 33609

2012.2916 **BOUNDARY SURVEY** HILLSBOROUGH COUNTY

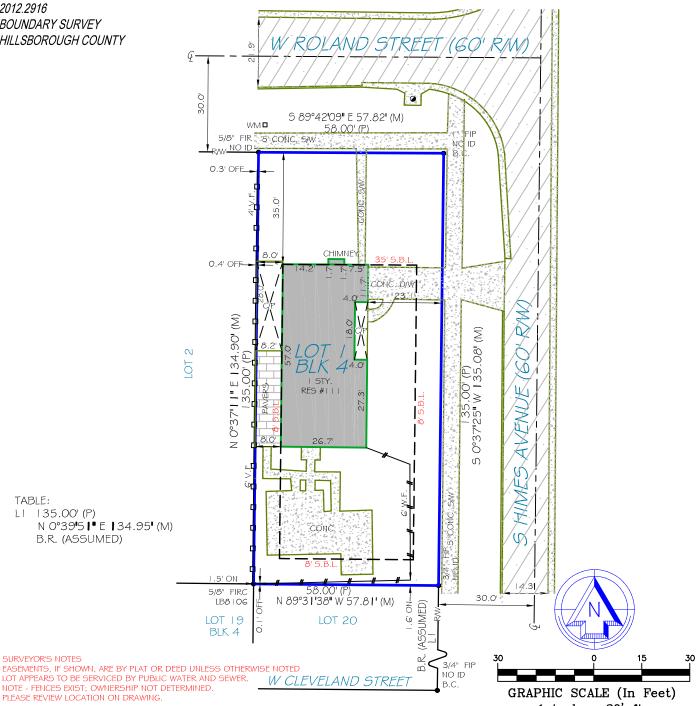

···BOYD ALLEN C. BOYD ALLEN

TABLE:

SURVEYORS CERTIFICATION:

I hereby certify that this Survey of the lands described hereon was made under my direct supervision, and to the best of my knowledge and belief is a true and accurate representation of said lands and meets the Standards of Practice set forth in Chapter 5J-15.050 through 5J -15.053, Florida Administrative Code, pursuant to section 472.027, Florida Statutes. This survey is not valid without the signature and original raised seal of a Florida licensed surveyor and mapper, except when the electronic signature and seal of a Florida licensed surveyor and mapper is affixed hereto.

POINTS OF INTEREST:

NONE VISIBLE



AFFILIATE MEMBERS



eyors, LLC LB# 8291 Office: 866.735.1916 | Fax: 866.744.2882 11940 Fairway Lakes Drive, Suite 1 | Fort Myers, FL 33913

DATE OF SURVEY: 12/18/20 FIELD WORK DATE: 12/15/2020 REVISION DATE(S): (REV.O 12/18/2020)

State of Florida Professional Surveyor and Mapper

License Number 3932

SEE PAGE 2 OF 2 FOR LEGAL DESCRIPTION PAGE 1 OF 2 - NOT VALID WITHOUT ALL PAGES

1 inch = 30' ft.

JOB SPECIFIC SURVEYOR NOTES:

THE ASSUMED BEARING REFERENCE OF N00°39'51"E IS BASED ON THE WESTERLY RIGHT-OF-WAY LINE OF S HIMES AVENUE, BON AIR, AS RECORDED IN PLAT BOOK 11, PAGE 5, OF THE PUBLIC RECORDS OF HILLSBOROUGH COUNTY, FLORIDA.

LEGAL DESCRIPTION:

LOT 1, BLOCK 4, BON AIR, AS RECORDED IN PLAT BOOK 11, PAGE 5, OF THE PUBLIC RECORDS OF HILLSBOURGH COUNTY, FLORIDA.

GENERAL SURVEYOR NOTES:

- The Legal Description used to perform this survey was supplied by others. This survey does not determine nor imply ownership. Unless otherwise noted, an examination of the abstract of title was NOT performed by the signing surveyor to determine which instruments, if any, are affecting this property.
- The purpose of this survey is to establish the boundary of the lands described in the legal description provided and to depict the visible improvements thereon. This survey only shows improvements found aboveground. Underground footings, utilities and encroachments where not located on this survey map.
- If there is a septic tank or drain field shown on this survey. the location depicted hereon was either shown to Exacta Land Surveyors, LLC. by a third party or it was estimated by visual above ground inspection only. No excavation was performed to determine the location.
- This survey is exclusively for the use of the parties to whom
- Additions or deletions to this Survey Map and Report by other than the signing surveyor is prohibited without written consent of the signing surveyor.

- 6. Dimensions are in feet and decimals thereof.
- 7. Any FEMA food zone data contained on this survey is for informational purposes only. Research to obtain said data was performed at www.fema.gov and may not reflect the most recent information.
- 8. Unless otherwise noted SIRC indicates a minimum 1/2 diameter, 18" long iron rebar with a cap stamped LB#8291.
- 9. If you are reading this survey in an electronic format, the information contained on this document is only valid if this document is electronically signed as specified in Chapter 5J17.062 (3) of the Florida Administrative Code and Florida Statute 472.025. The Electronic Signature File related to this document is prominently displayed on the invoice for this survey which is sent under separate cover. Manually signed and sealed logs of all survey signature files are kept in the office of the performing surveyor.
- 10. The symbols reflected in the legend and on this survey may have been enlarged or reduced for clarity. The symbols have been plotted at the approximant center of the field location and may not represent the actual shape or size of
- 11. Points of Interest (POI's) are selected above-ground improvements, which may appear in conflict with boundary, building setback or easement lines, as defined by the parameters of this survey. There may be additional POI's which are not shown or called-out as POI's, or which are otherwise unknown to the surveyor. These POI's may not represent all items of interest to the viewer.

SURVEY NUMBER: FL2012.2916

- 12. Utilities shown on the subject property may or may not indicate the existence of recorded or unrecorded utility easements.
- 13. The information contained on this survey has been performed exclusively by and is the sole responsibility of Exacta Land Surveyors, LLC. Additional logo's or references to third party firms are for informational purposes only.
- 14. Pursuant to F.S. 558.0035, an individual employee or agent may not be held individually liable for negligence.
- 15. Due to varying construction standards, house dimensions are approximate and should not be used for new construction or planning. All measurements should be verified prior to such activity.

SURVEYOR'S LEGEND

	LINETYPES		
	Boundary Line		
	Center Line		
***	Chain Link or Wire Fence		
	Easement		
	Edge of Water		
-00-	Iron Fence		
—OHL—	Overhead Lines		
	Structure		
	Survey Tie Line		
1-0-0-0-0	Vinyl Fence		
	Wall or Party Wall		
" "	Wood Fence		
SU	SURFACE TYPES		
	Asphalt		
>>>>	Brick or Tile		
	Concrete		
><(Covered Area		
	Water		
11///	Wood		
	SYMBOLS		
⊕	Benchmark		
Q.	Center Line		
Δ	Central Angle or Delta		
\mathcal{M}	Common Ownership		
	Control Point		
	Catch Basin		

-	Elevation
7	Fire Hydrant
•	Find or Set Monument
\leftarrow	Guywire or Anchor
(4)	Manhole
₩	Tree
\$	Utility or Light Pole
_ w _	Well

ABBREVIATIONS

(C) - Calculated (**D**) - Deed

(F) - Field

(M) - Measured

(P) - Plat

(S) - Survey

A/C - Air Conditioning

AE - Access Easement

ANE - Anchor Easement ASBL - Accessory Setback Line

B/W - Bay/Box Window

BC - Block Corner

BFP - Backflow Preventer

BLDG - Building

BLK - Block

BR - Bearing Reference

BRL - Building Restriction Line

BSMT - Basement

C - Curve C/L - Center Line

C/P - Covered Porch

C/S - Concrete Slab

CATV - Cable TV Riser

CB - Concrete Block CH - Chord Bearing

CHIM - Chimney CLF - Chain Link Fence

CME - Canal Maintenance

Easement

co - Clean Out

CONC - Concrete

COR - Corner CS/W - Concrete Sidewalk

CUE - Control Utility Easement

CVG - Concrete Valley Gutter

D/W - Driveway

DE - Drainage Easement

DF - Drain Field

DH - Drill Hole

DUE - Drainage & Utility

ELEV - Elevation EM - Electric Meter

ENCL - Enclosure

ENT - Entrance

EOP - Edge of Pavement

EOW - Edge of Water

ESMT - Easement EUB - Electric Utility Box

F/DH - Found Drill Hole

FCM - Found Concrete Monument

FF - Finished Floor

FIP - Found Iron Pipe FIPC - Found Iron Pipe & Cap FIR - Found Iron Rod

FIRC - Found Iron Rod & Cap

FN - Found Nail

FN&D - Found Nail & Disc

FRRSPK - Found Rail Road

GAR - Garage

GM - Gas Meter

ID - Identification

IE/EE - Ingress/Egress Easement ILL - Illegible

INST - Instrument

INT - Intersection

IRRE - Irrigation Easement

L - Length

LAE - Limited Access Easement

LB# - License No. (Business)

LBE - Limited Buffer Easement

LE - Landscape Easement

LME - Lake/Landscape Maintenance Easem

LS# - License No. (Surveyor)

MB - Map Book

ME - Maintenance Easement MES - Mitered End Section

MF - Metal Fence

MH - Manhole

NR - Non-Radial NTS - Not to Scale

NAVD88 - North American

Vertical Datum 1988

NGVD29 - National Geodetic Vertical Datum 1929

ORB - Official Records Book **ORV** - Official Record Volume

O/A - Overall

O/S - Offset

OFF - Outside Subject Property OH - Overhang

OHL - Overhead Utility Lines

ON - Inside Subject Property

P/E - Pool Equipment PR - Plat Book

PC - Point of Curvature

PCC - Point of Compound

Curvature

PCP - Permanent Control Point PI - Point of Intersection

PLS - Professional Land Survevoi

PLT - Plante

POB - Point of Beginning

POC - Point of Commencement PRC - Point of Reverse

PRM - Permanent Reference

PSM - Professional Surveyor

& Mappei PT - Point of Tangency

PUE - Public Utility Easement

R - Radius or Radial

R/W - Right of Way

RES - Residential

RGE - Range ROE - Roof Overhang Easement

RP - Radius Point

S/W - Sidewalk

SBL - Setback Line SCL - Survey Closure Line

SCR - Screen

SEC - Section

SEP - Septic Tank

SEW - Sewer SIRC - Set Iron Rod & Cap

SMWE - Storm Water Management Easeme

SN&D - Set Nail and Disc

SQFT - Square Feet

STL - Survey Tie Line

STY - Story

SV - Sewer Valve SWE - Sidewalk Easemen

TBM - Temporary Bench Mark

TEL - Telephone Facilities

TOB - Top of Bank

TUE - Technological Utility

TWP - Township

TX - Transformer

TYP - Typical

UE - Utility Easer **UG -** Underground

UP - Utility Pole

UR - Utility Riser **VF -** Vinyl Fence

W/C - Witness Corner

W/F - Water Filter WF - Wood Fence

WM - Water Meter/Valve Box WV - Water valve

CERTIFIED TO:

THOMAS LLOYD VIRDEN III; ZILLOW CLOSING SERVICES; WESTCOR LAND TITLE INSURANCE COMPANY; TOWNE MORTGAGE COMPANY

FLOOD ZONE INFORMATION: BY PERFORMING A SEARCH WITH THE LOCAL GOVERNING

DATE OF SURVEY: 12/18/20

BUYER: THOMAS LLOYD VIRDEN III

SELLER: SPH PROPERTY ONE, LLC **CLIENT FILE NO: 2011-FL-107872**

TITLE COMMITMENT:

MUNICIPALITY OR WWW.FEMA.GOV, THE PROPERTY APPEARS TO BE LOCATED IN ZONE X. THIS PROPERTY WAS FOUND IN THE CITY OF **TAMPA** COMMUNITY NUMBER 120114, PANEL NUMBER 0334 DATED 08/28/2008.

> LB# 8291 Office: 866.735.1916 | Fax: 866.744.2882 11940 Fairway Lakes Drive, Suite 1 | Fort Myers, FL 33913

SEE PAGE 1 OF 2 FOR MAP OF PROPERTY PAGE 2 OF 2 - NOT VALID WITHOUT ALL PAGES